



POMOĆNA ZGRADA - A
TLOCRT PRIZEMLJA - IZVEDENO STANJE
MJ 1:100

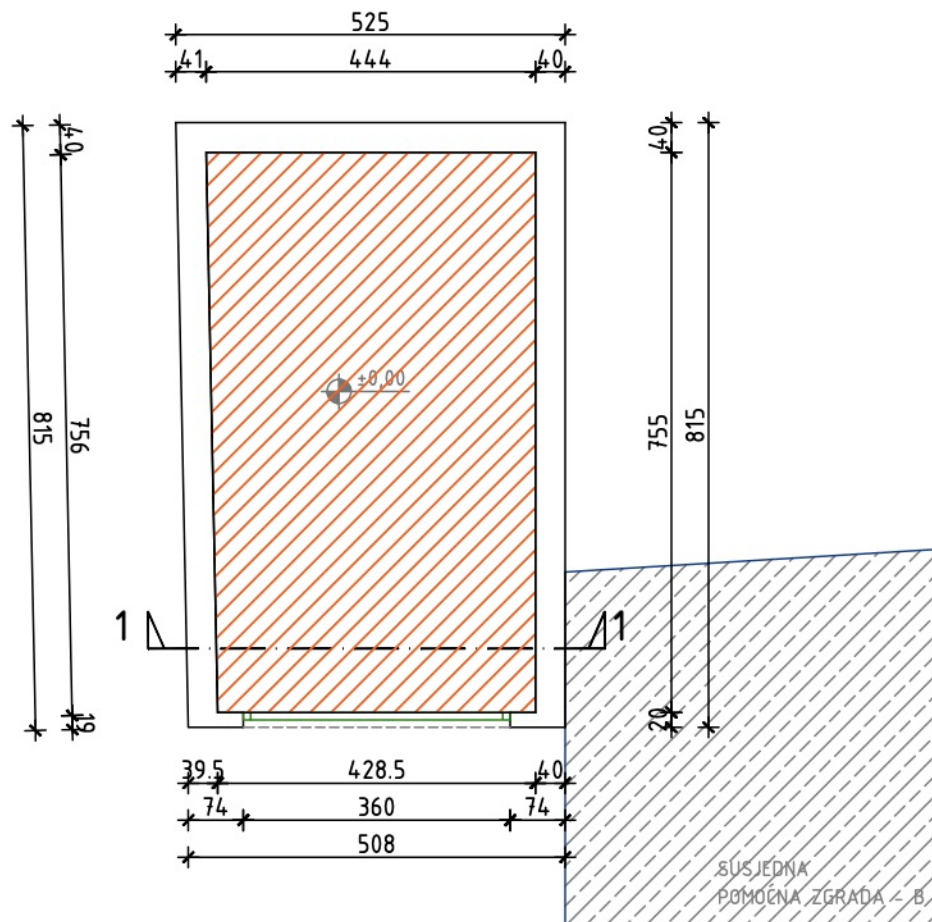

POMOĆNA ZGRADA - A
PRESJEK 1-1 - IZVEDENO STANJE
MJ 1:100

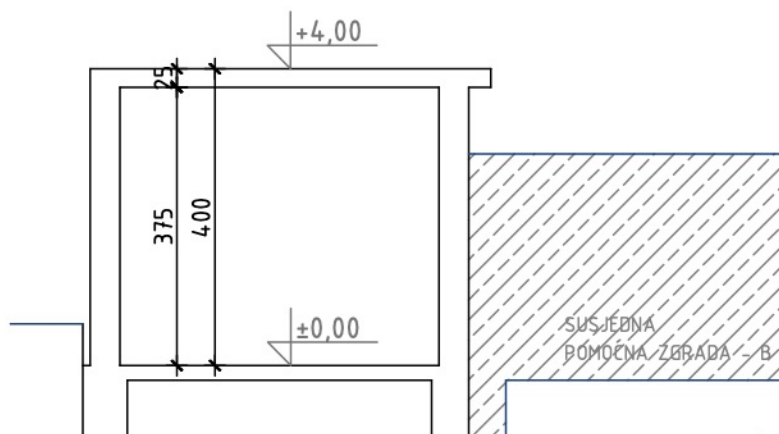

	STUDIO PROJEKT inženjering, gradenje, konzalting i trgovina Ljubjska 79, Zagreb	
PODNOŠITELJ	Jozo Renić	
GRADEVINA	Stambena zgrada k.č.br.3506/20, k.o.Šestine; Šestinski vrh 41A	
PLAN POSEBNIH DIJELOVA NEKRETNOSTI		
SADRŽAJ	Pomoćna zgrada A – garaža	
PROJEKTANT	IVAN VUČIĆ, dipl.ing.grad.	
LIST br. 06	DATUM: travanj 2021.	MJERILO: 1 : 100